


- FLAG NOTES**
- 1 TO AV RACK LOCATED IN SAME ROOM.
 - 2 WALL MOUNTED AV RACK AVR002. COORDINATE FINAL LOCATION WITH ARCHITECT AND OWNER.
 - 3 FLOOR MOUNTED AV RACK AVR001.
 - 4 DVD AND VCR LOCATED IN OWNER SUPPLIED CABINET.
 - 5 VOLUME CONTROL WITH PRIORITY PAGING BYPASS.
 - 6 WALL MOUNTED AV RACK AVR005.
 - 7 FLUSH CEILING MOUNTED ELECTRIC FRONT PROJECTION SCREEN.
 - 8 TERMINATE CONDUIT INTO OVERHEAD CABLE TRAY.
 - 9 TO BE MOUNTED AT 46" ABOVE FINISHED FLOOR.
 - 10 OWNER PROVIDED KIOSK.
 - 11 NO FACEPLATE REQUIRED, TO BE ROUTED THROUGH MOUNTING POLE AND TERMINATED AT TELEVISION.
 - 12 TYPICAL OF (2) CATV JACKS. NO FACEPLATE REQUIRED TO BE ROUTED TO RACK WITH 8" SLACK LOOP WITH ENDS TERMINATED.

FLOOR PLAN - AREA A
Scale: 1/8"=1'-0"

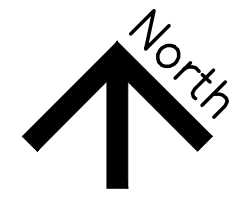


This Record Drawing has been prepared based on information provided by others. The Engineer has not verified the accuracy of this information and shall not be responsible for any errors or omissions which may be incorporated herein as a result.

06/04/10


© COPYRIGHT 2008 IPDG#200523610
Permission to reproduce all or part of this Drawing is hereby granted solely for the limited purpose of construction of this project or archiving.
Unauthorized copying, disclosure or construction use without written permission of IP Design Group is prohibited by copyright law.

NOTE:
DO NOT SCALE DRAWINGS. VERIFY ALL DIMENSIONS and clearances from ARCHITECTURAL, STRUCTURAL, shop and other appropriate drawing or at site. Lay out and coordinate all work prior to installation to provide clearances required for operation, maintenance, and codes and verify non-interference with other work. DO NOT FABRICATE PRIOR TO VERIFICATION OF CLEARANCE FOR ALL TRADES. READ SPECIFICATIONS.

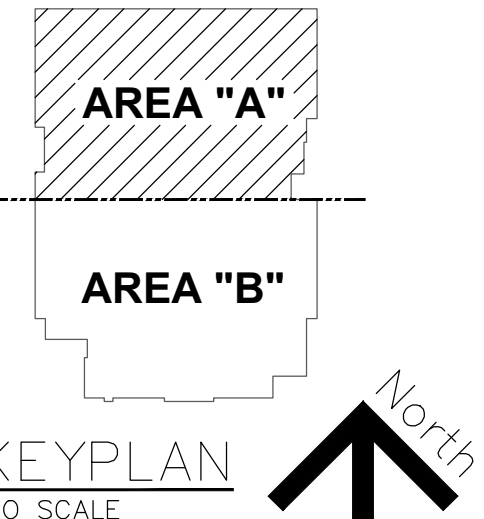


KEYPLAN
NO SCALE

DESIGN GROUP
1102 Douglas on the Mall Phone: (402) 346-7007
Omaha, Nebraska 68102 Fax: (402) 346-9576

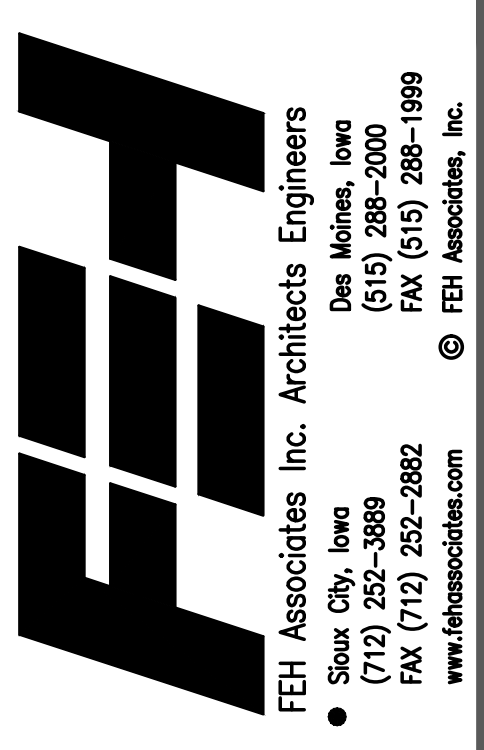

In Association With
• A/E INC.
• ARCHITECTURAL GROUP
• ELECTRICAL ENGINEERS INC.
• THE WHEELS GROUP

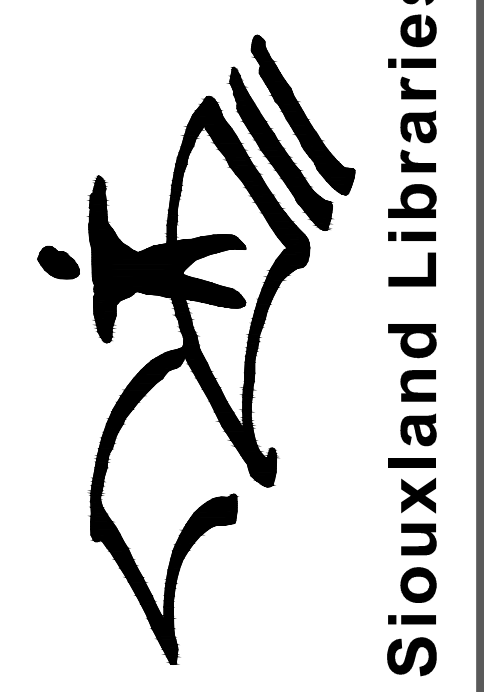

FLOOR PLAN
AREA A

Project Title
Main Library and Expansion
201 N. Main Avenue
Sioux Falls, SD 57104

Date Revised
09/18/2008

Project Number
2005236

Sheet
AV1.1A